

ADDENDUM NUMBER 1

Issued: July 2, 2008

Water Transmission System Air Valve Upgrade - Phase 1

FROM: Sonoma County Water Agency
PO Box 11628
Santa Rosa, CA 95406-1628

TO: Prospective Bidders

This Addendum forms a part of and modifies the Project Manual dated June 2008. Bidder shall acknowledge receipt of this Addendum in the space provided in Document 00400 (Bid Form).

Addendum Number 1 consists of 16 pages. Modified text is indicated as follows: Double-underline designates text to be inserted; ~~strikethrough~~ designates text to be deleted.

I. General Changes

A. No changes.

II. Changes to Prior Addenda

A. N/A.

III. Changes to Introductory Information and Bidding Requirements

A. Document 00450 (Statement of Qualifications for Construction Work):

1. General Change:

a. Title of Attachment A, and at all other occurrences, modify as follows:

~~Surety Bonding Form~~ Letter of Assurance Regarding Performance and Payment Bonds

2. Paragraph 1.C, modify as follows:

C. Human and Physical Resources. Identify, describe, and quantify for Bidder ~~and separately for Bidder's "designated Subcontractor(s)" (as defined in Document 00200 Instructions to Bidders)~~, the following technical resources for the Work:

3. Attachment C, Part A, delete Paragraph 5 and replace with the following:

5. Labor Commissioner assessments or determination of ineligibility to bid:

a. Has Bidder had a final civil wage and penalty assessment against it from the Labor Commissioner more than twice in the last five years? Yes _____ No _____

b. Has Bidder been determined by the Labor Commissioner to be ineligible to bid on public contracts more than twice in the last five years? Yes _____ No _____

4. Attachment C, Part A, delete note following Paragraph 5 and replace with the following:
**Bidder will be immediately disqualified if any answer to questions 1 or 2 is No.
Bidder will be immediately disqualified if any answer to questions 3, 4, 5.a, or 5.b is Yes.**
5. Bidder shall use the revised Document 00450 (Statement of Qualifications for Construction Work) attached, marked "REVISED 7/2/08" in its Bid.

IV. Changes to Contracting Requirements

- A. No changes.

V. Changes to Conditions of the Contract

- A. No changes.

VI. Changes to Specifications

- A. Section 15051 (Basic Piping Materials and Methods):
 1. Insert the following as Paragraph 1.3D.1.c:
 - c. Hot tapping:
 - 1) Hot tap method
 - 2) Hot tap apparatus manufacturer's operating instructions manual
 2. Insert the following as Paragraph 3.5A.4:
 4. Provide 1/2" annular space around vent pipe and vault or box penetration. Seal annular spacer per Paragraph 3.5A.3 above.
- B. Section 15142 (Plastic Pipe):
 1. Delete Paragraph 2.2D in its entirety and replace with the following:
 - D. Provide with type 304 Stainless Steel No. 10 mesh screen

VII. Changes to Drawings



- A. Drawing Number D-1, in the table entitled LIST OF MATERIALS 2" COMBINATION AIR VALVE ASSEMBLY:
 1. Modify Item B description as follows:
UTILITY BOX (24"X36") WITH BOLT DOWN LID, ~~USE WITH~~ PVC OR CONC SUPPORT BLOCKS (TWO PER BOX), LABEL "SCWA"
 2. Modify Item PP description with the following:
CONC COLLAR, EXTENDING 8" MINIMUM BEYOND BOX PERIMETER AND 6" BELOW HAUNCH OF BOX, WITH ONE #3 REBAR HOOP
- B. Drawing Number D-2, in the table entitled LIST OF MATERIALS 2" COMBINATION AIR VALVE ASSEMBLY:
 1. Modify Item B description as follows:
UTILITY BOX (24"X36") WITH BOLT DOWN LID, ~~USE WITH~~ PVC OR CONC SUPPORT BLOCKS (TWO PER BOX), LABEL "SCWA"
 2. Modify Item HH description as following:
SUPPORT BLOCK ~~PER BOX MANUFACTURER'S RECOMMENDATION, TYP~~
 3. Modify Item PP description as following:
CONC COLLAR, EXTENDING 8" MINIMUM BEYOND BOX PERIMETER AND 6" BELOW HAUNCH OF BOX, WITH ONE #3 REBAR HOOP

C. Drawing Number D-3, in the table entitled LIST OF MATERIALS 2" COMBINATION AIR VALVE ASSEMBLY:

1. Modify Item B description as follows:
UTILITY BOX (24"X36") WITH BOLT DOWN LID, USE WITH PVC OR CONC SUPPORT BLOCKS (TWO PER BOX), LABEL "SCWA"
2. Delete Item HH
3. Modify Item PP description with the following:
CONC COLLAR, EXTENDING 8" MINIMUM BEYOND BOX PERIMETER AND 6" BELOW HAUNCH OF BOX, WITH ONE #3 REBAR HOOP

D. Drawing Number D-4:

1. In the table entitled LIST OF MATERIALS COMBINATION AIR VALVE VENT PIPING, delete Item N description and replace with the following:
SUCTION STRAINER
2. Delete details 3 and 4 and replace with the following details 3 and 4:

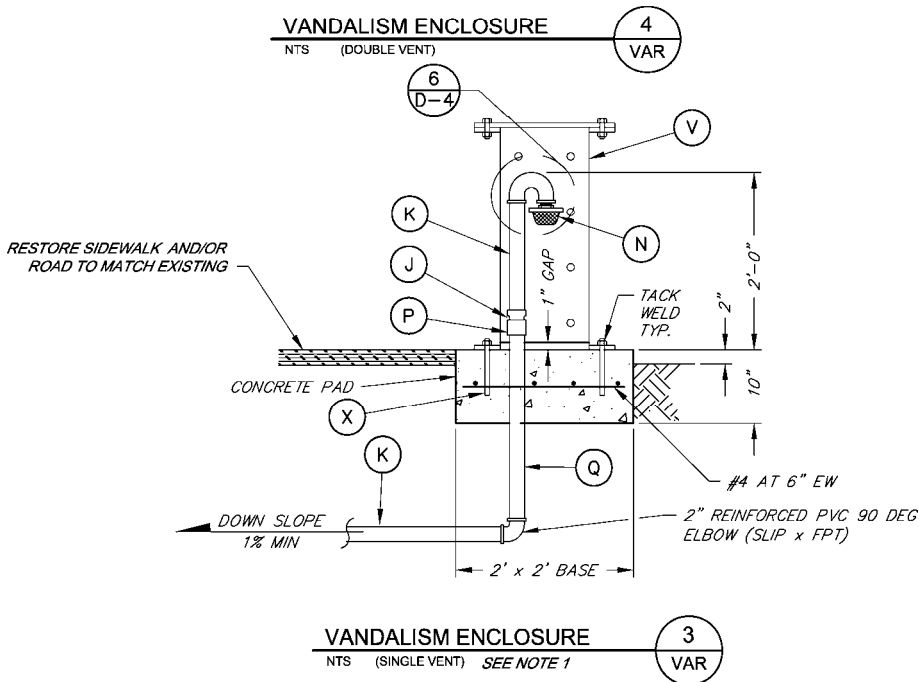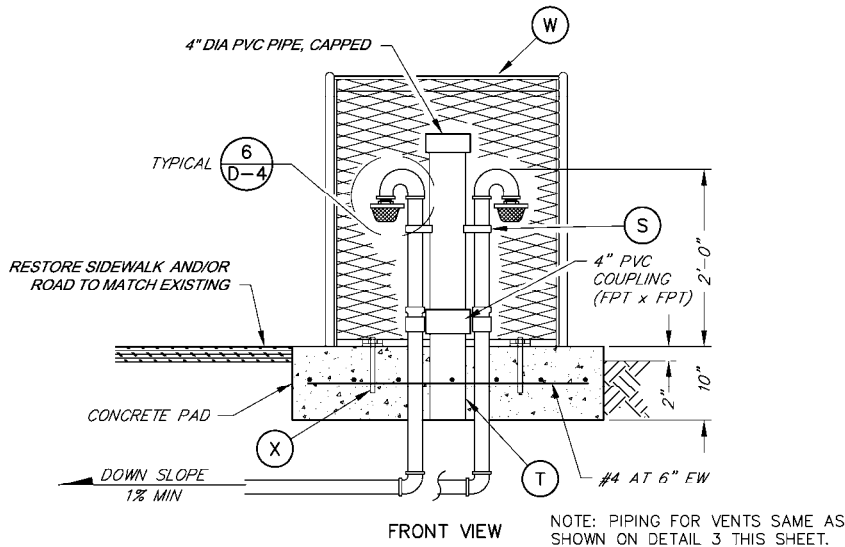

VIII. Question(s)/Answer(s)

A. No questions received as of issue date of this Addendum Number 1.

END OF DOCUMENT